


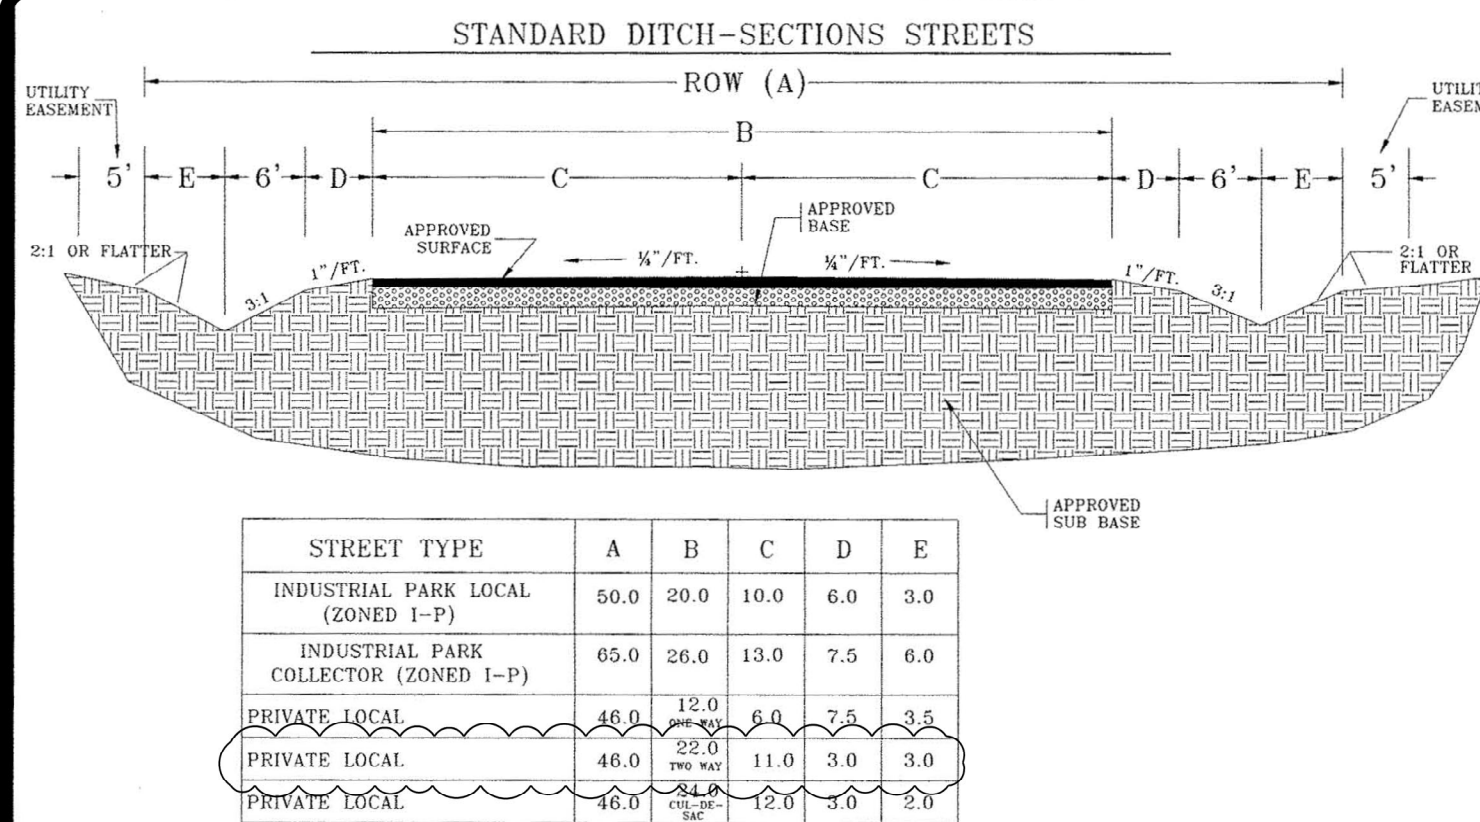

STANDARD DITCH SECTIONS FOR STREETS				
REVISIONS		CITY OF ROCKY MOUNT DEPT. OF ENGINEERING	APPROVED -	STD. NO.
NO	DATE DESCRIPTION		DATE	23
			10-02-08	REVISION -

PAVEMENT LEGEND

- 100** PAVEMENT RE-SURFACING

2"± S9.5B ASPHALT
EX. ASPHALT (2"±)
EX CABC (MIN 6")
EX SUBGRADE

101 ROAD WIDENING

2"± S9.5B ASPHALT
1½" B25.0C
6" #57 STONE
COMPACTED SUBGRADE

2"± S9.5B ASPHALT
EX. ASPHALT (OR STONE)
EX CABC
EX SUBGRADE

0 TO 4'

102 PAVING UNSURFACED ROAD


2"± S9.5B ASPHALT
0-2" CABC AS DIRECTED BY CITY
EX CABC
EX SUBGRADE

103 PIPE COVER

15" RCP

10" MIN

* SEE CRM 1.06 FOR BEDDING DETAILS

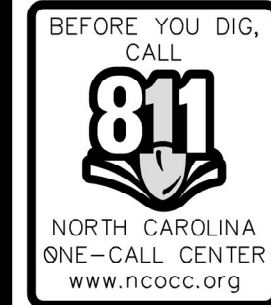

These plans are for bidding purposes only and are not to be used as Construction drawings unless initialed and dated as approved for Construction below by the Engineer.

Approved for Construction: _____ Date: _____

BOUNDARY DESCRIPTION SHOWN
IS NOT FOR RECORDATION.

RECORD DRAWINGS:

These drawings are believed to be a correct representation of actual field conditions but are not warranted as such.

CONSTRUCTION SAFETY

These drawings do not contain the requirements for job safety. All provisions for safety shall be the sole responsibility of the contractor.


EXISTING CONDITIONS:

The contractor shall be responsible for reviewing all existing job conditions. Any adverse existing conditions affecting work shown on these drawings shall be brought to the attention of the engineer for possible clarification or reconciliation.

ADA AND LEGAL DISCLAIMER

This document is not represented to comply with all requirements contained in the ADA or other laws. Engineers are not licensed to interpret laws or give advice concerning laws, the owner should have this document reviewed by his attorney to determine legal compliance.

CONTOURS SHOWN ARE FROM NCDOT AND ARE SHOWN FOR REFERENCE ONLY

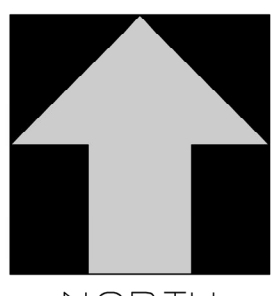

SCOPE OF WORK:

STREET NAME	EX. ROAD SURFACE	PRO. WORK DESCRIPTION	APPROX. LENGTH (LF)	APPROX. AREA (SY)	DETAIL
Lewy Lane	ABC	Paving, ditch regrading	975	2,300	100
Triple Court	ABC	Paving, ditch regrading	240	860	100
Vans Drive	Asphalt	Resurfacing	700	2,150	102
Fort Street	Asphalt	Resurfacing	850	2,150	102

Note: Road widening required in multiple areas (not shown) to maintain 22' asphalt width per CRM Detail 2.3. Install road widening per **Detail 101**.



CONSULTING ENGINEERS, P.A.
CIVIL, MUNICIPAL &
STRUCTURAL ENGINEERS
BLN = C0562

154 Roundabout Ct.
P.O. Box 7966
Rocky Mount, N.C. 27804
Phone: (252) 972-7703

www.appianengineers.com
admin@appianengineers.com

THESE PLANS WERE
PRINTED USING COLOR.
IF THIS NOTE IS NOT SHOWN
IN RED, PLEASE REFER TO
ORIGINAL PLANS.

**Final Drawings
Review Purposes ONLY**



**Overall Existing Conditions for
Dirt Street Paving Project:
Lewy Lane & Triple Court
Edgecombe County, Rocky Mount, N.C.**

21-124
D-0000
CE-1